
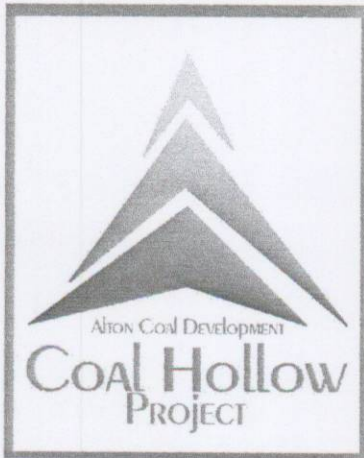


## RECORD DRAWING

# FUEL CONTAINMENT

COAL HOLLOW  
PROJECT  
ALTON, UTAH

DRAWING: C2.0

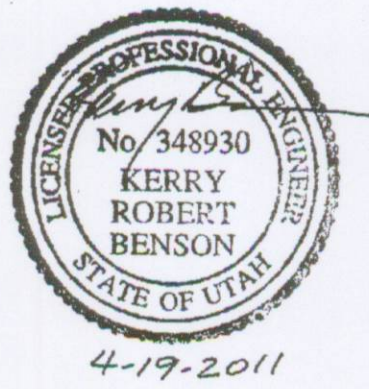

463 North 100 West, Suite 1  
Cedar City, Utah 84720  
Phone (435)867-5331  
Fax (435)867-1192

CONSULTANT:



**LESLIE & ASSOCIATES**  
444 South Main Street  
Cedar City, Utah 84720  
Phone: (435)586-9474  
FAX: (435)586-8399

LEGEND:

DRAWN BY:  
J. LESLIE

DRAWING:  
**RECEIVED**  
JUL 05 2011

OF OIL, GAS & MINING

JOB NUMBER.  
594-01-01

CHECKED BY:  
KRB

DATE:  
11/08/2010

SCALE:  
As Noted

## REVISIONS

DATE: \_\_\_\_\_  
/19/2011

BY:  
KRB